EXHIBIT B

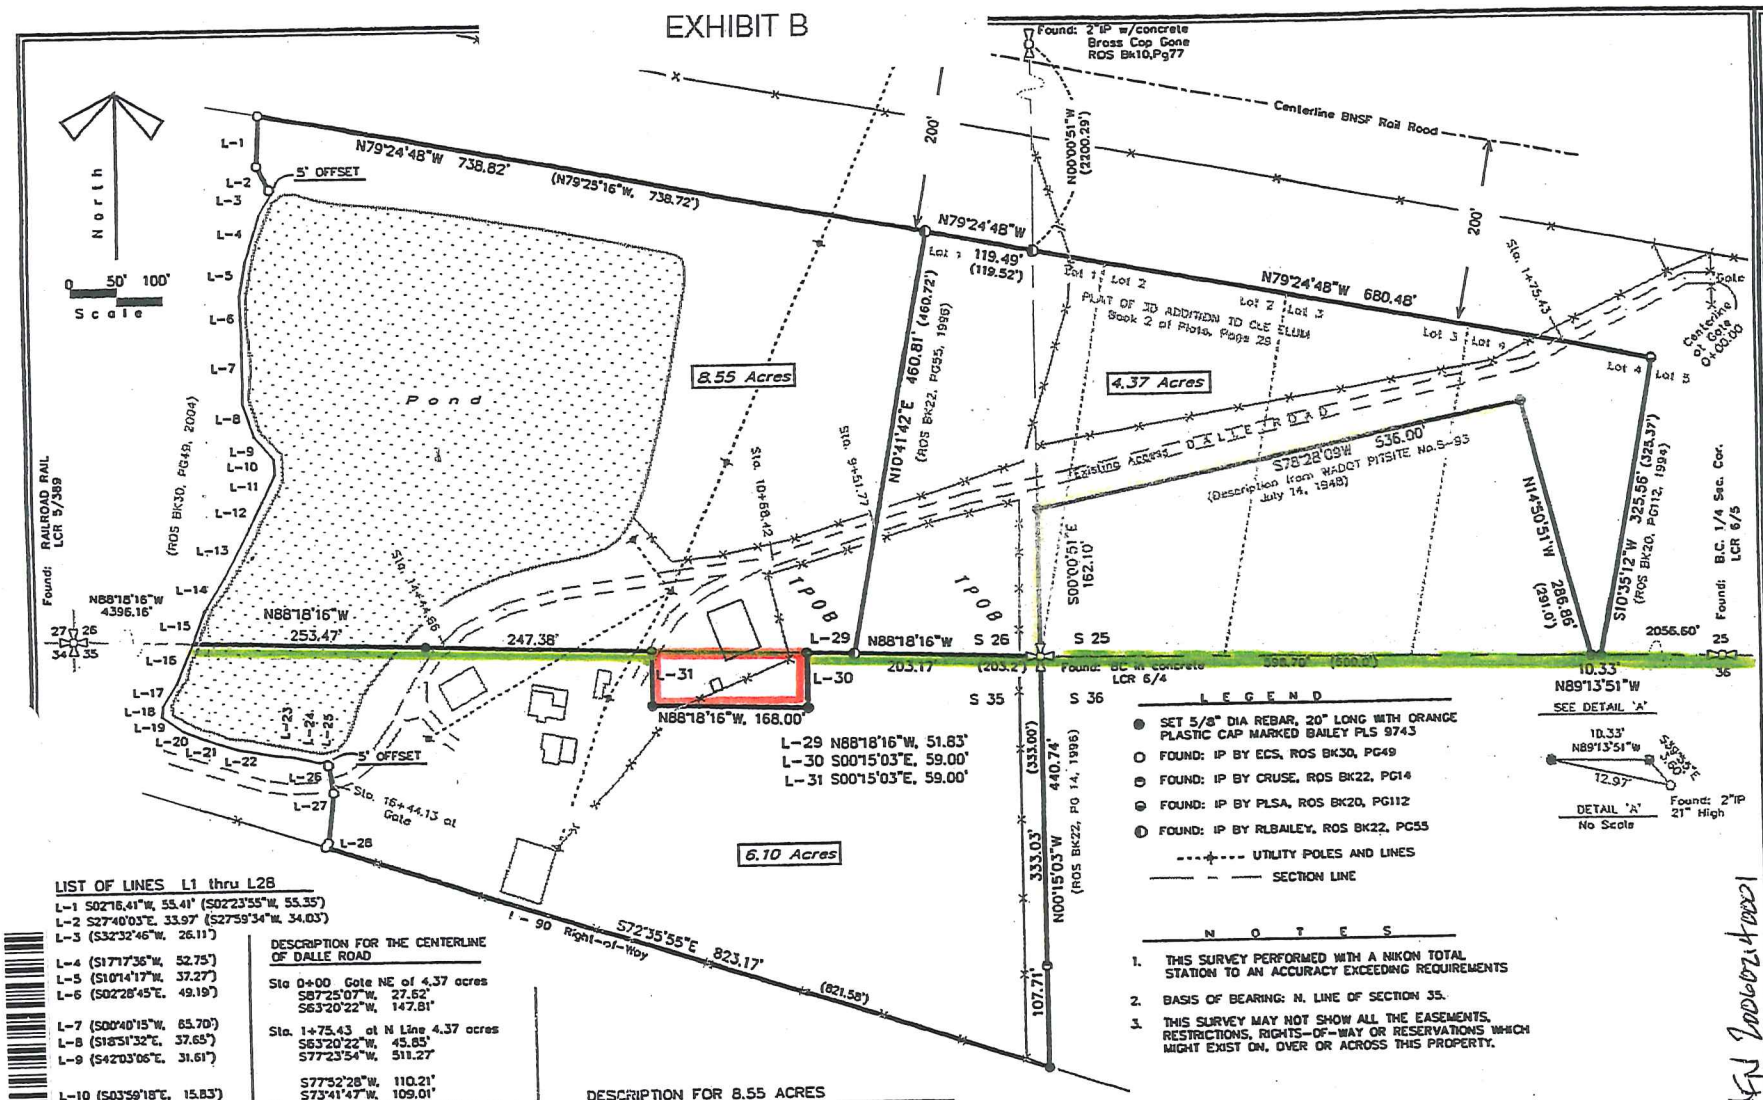

LIST OF LINES L1 thru L28

L-1 S02°16'41"W, 55.41' (S02°23'55"W, 55.35')
L-2 S27°40'03"E, 33.97' (S27°59'34"W, 34.03')
L-3 (S32°32'46"W, 26.11')
L-4 (S17°17'36"W, 52.75')
L-5 (S10°14'17"W, 37.27')
L-6 (S02°28'45"E, 49.19')
L-7 (S00°40'15"W, 65.70')
L-8 (S18°51'32"E, 37.65')
L-9 (S42°03'06"E, 31.61')
L-10 (S03°59'18"E, 15.83')
L-11 (S25°48'02"W, 33.70')
L-12 (S26°32'33"W, 38.72')
L-13 (S28°42'53"W, 53.52')
L-14 (S31°12'35"W, 41.79')
L-15 (S20°44'23"W, 37.71')
L-16 (S23°19'04"W, 48.15')
L-17 (S33°09'27"W, 28.27')
L-18 (S06°19'59"W, 10.89')
L-19 (S55°25'53"E, 29.93')
L-20 (S69°05'25"E, 25.56')
L-21 (S71°51'38"E, 34.58')
L-22 (S80°29'02"E, 45.13')
L-23 (S85°03'41"E, 18.13')
L-24 (S76°50'25"E, 27.99')
L-25 (N74°59'26"E, 8.43')
L-26 (S10°02'00"E, 35.27')
L-27 S06°57'01"W, 54.47' (S06°57'43"W, 54.50')
L-28 S37°15'19"W, 5.44' (S36°46'59"W, 5.45')

DESCRIPTION FOR THE CENTERLINE OF DALLE ROAD

Sta 0+00 Gate NE of 4.37 acres
S87°25'07"W, 27.62'
S63°20'22"W, 147.81'

Sta. 1+75.43 at N Line 4.37 acres
S63°20'22"W, 45.85'
S77°23'54"W, 511.27'

S77°32'28"W, 110.21'
S73°41'47"W, 109.01'
Sta. 9+51.77 at W Line 4.37 acres

S73°41'47"W, 116.65'
S81°46'32"W, 105.77'
S81°34'11"W, 124.49'

S75°34'03"W, 67.00'
S64°13'05"W, 49.76'
S47°22'21"W, 29.22'

Sta. 14+44.66 at N Line 6.10 acres
S34°56'28"W, 52.12'
S29°43'02"W, 48.72'

S36°07'08"W, 45.62'
S53°21'10"W, 27.26'
S72°29'27"W, 25.75'

Sta. 16+44.13 Gate at W. End 6.10 ac.

DESCRIPTION FOR 8.55 ACRES

THOSE PORTIONS OF THE NE4, SEC. 35 AND THE SE4, SEC. 26 ALL SITUATED IN KITTITAS COUNTY, STATE OF WASHINGTON MORE PARTICULARLY DESCRIBED AS FOLLOWS:

BEGINNING AT THE SE CORNER OF SEC. 26; THENCE N88°18'16"W ALONG THE S.LINE OF SAID SE4, SEC. 26, 203.17' TO THE TRUE POINT-OF-BEGINNING WHICH IS ALSO THE SW CORNER OF THE 3RD ADDITION TO CLE ELUM; THENCE N10°41'42"E ALONG THE WEST LINE OF THE 3RD ADDITION TO CLE ELUM 460.81' TO INTERSECT WITH THE S.BOUNDARY OF THE BNSF RAILROAD RIGHT-OF-WAY; THENCE N79°24'48"W ALONG SAID R/W, 738.82'; THENCE S02°16'41"W, 55.41'; THENCE S27°40'03"E, 33.97'; THENCE S32°32'46"W, 26.11'; THENCE S17°17'36"W, 52.75'; THENCE S10°14'17"W, 37.27'; THENCE S02°28'45"E, 49.19'; S00°40'15"W, 65.70'; THENCE S18°51'32"E, 37.65'; THENCE S42°03'06"E, 31.61'; THENCE S03°59'18"E, 15.83'; THENCE S25°48'02"W, 33.70'; THENCE S26°32'33"W, 38.72'; THENCE S28°42'53"W, 53.52'; THENCE S31°12'35"W, 41.79'; THENCE S20°44'23"W, 37.71' TO INTERSECT WITH THE S.LINE OF SAID SE4, SEC. 26; THENCE S88°18'16"E ALONG SAID S.LINE, 500.85'; THENCE S00°15'03"E, 59.00'; THENCE S88°18'16"E, 168.00'; THENCE N00°15'03"W, 59.00' TO INTERSECT WITH THE S.LINE OF SAID SE4, SEC.26; THENCE S88°18'16"E ALONG SAID S.LINE OF SAID SE4, SEC.26, 51.83' TO THE TRUE POINT-OF-BEGINNING;

CONTAINING 8.55 ACRES

AND SUBJECT TO ALL RESERVATIONS, RESTRICTIONS, EASEMENTS AND RIGHTS-OF-WAY APPARENT OR OF RECORD.

DESCRIPTION FOR 6.10 ACRES

THAT PORTION OF THE NE4, SEC. 35, T20N, R15E, WM ALL SITUATED IN KITTITAS COUNTY, STATE OF WASHINGTON MORE PARTICULARLY DESCRIBED AS FOLLOWS:

BEGINNING AT THE NE SEC. COR. OF SAID SECTION WHICH IS ALSO THE TRUE POINT-OF-BEGINNING THENCE: N88°18'16"W ALONG THE N. LINE OF SAID NE4 253.00'; THENCE S00°15'03"E, 59.00'; THENCE N88°18'16"W, 168.00'; THENCE N00°15'03"W, 59.00' TO INTERSECT WITH THE N. LINE OF SAID NE4; THENCE N88°18'16"W ALONG SAID N.LINE 500.85'; THENCE S25°19'04"W, 48.15'; THENCE S33°09'27"W, 28.27'; THENCE S06°19'59"W, 10.89'; THENCE S55°25'53"E, 29.93'; S69°05'25"E, 25.56'; THENCE S71°51'38"E, 34.58'; THENCE S80°29'02"E, 45.13'; THENCE S85°03'41"E, 18.13'; THENCE S76°50'25"E, 27.99'; THENCE N74°59'26"E, 8.43'; THENCE S10°01'44"E, 35.25'; THENCE S06°57'01"W, 54.47'; THENCE S37°15'19"W, 5.44' TO INTERSECT WITH THE N.BOUNDARY OF THE I-90 RIGHT-OF-WAY; THENCE S72°35'55"E ALONG SAID R/W BOUNDARY, 823.17' TO INTERSECT WITH THE E.LINE OF SAID NE4; THENCE N00°15'03"W ALONG THE SAID E.LINE, 440.73' TO THE TRUE POINT-OF-BEGINNING;

CONTAINING 6.10 ACRES

AND SUBJECT TO ALL RESERVATIONS, RESTRICTIONS, RIGHTS-OF-WAY AND EASEMENTS APPARENT OR OF RECORD

DESCRIPTION FOR 4.37 ACRES

THOSE PORTIONS OF THE SE4, SEC. 26 AND THE SW OF THE SW4, SEC. 25, T20N, R15E, WM ALL SITUATED IN KITTITAS COUNTY, STATE OF WASHINGTON MORE PARTICULARLY DESCRIBED AS FOLLOWS:

BEGINNING AT THE SE SEC.COR OF SEC. 26 WHICH IS ALSO THE TRUE POINT-OF-BEGINNING; THENCE N88°18'16"W, 203.17'; THENCE N10°41.42"E, 460.81' TO THE SOUTHERLY BOUNDARY OF THE BNSF RR RIGHT-OF-WAY; THENCE S79°24'48"E ALONG SAID R/W 799.97'; THENCE S10°35'12"W, 325.56' TO THE S. LINE OF SAID SW4, SEC.25; THENCE N89°13'51"W ALONG THE S. LINE OF SAID SW4, 10.33'; THENCE N14°50'51"W, 286.86'; THENCE S78°28'00"W, 536.00' TO THE W. LINE OF SAID SW4; THENCE S00°00'51"E ALONG SAID W. LINE 162.10' TO THE TRUE POINT-OF-BEGINNING;

CONTAINING 4.37 ACRES;

SUBJECT TO ALL RIGHTS-OF-WAY, RESTRICTIONS, RESERVATIONS AND EASEMENTS APPARENT OR OF RECORD.

RENO DALLE ESTATE
c/o DARREL ELLIS, Attorney
105 E. First St. Cle Elum, Wa. 98922

R.L.BAILEY & ASSOCIATES
4201 HWY 970, CLE ELUM, WA 98922
509 674 5551

record survey for

by

AUDITOR'S CERTIFICATE
Filed for record this 14 day of Feb a.m. 20 01 at ___
in Book 22 of Surveys, Page 106 at the request of ROBERT L. BAILEY
Auditor Deputy Auditor

SW4 S.25; SE4 S.26; NE4 S.35; T20N, R15E, W.M.

SURVEYOR'S CERTIFICATE
This map correctly represents a survey made by me in conformance with the requirements of the Survey Recording Act at the request of Shirley Dolle
ROBERT L. BAILEY, PE/PLS 9743

$45.00
Ordinance
Kittitas County Auditor
CITY CLE ELUM